Qty:

Date:

Thursday, 05/03/2009 10:30:52 AM

User:

Julie Dawson

**Process Sheet** 

Customer

: CU-DAR001 Dart Helicopters Services

Job Number : 13652 **Estimate Number** 

: 46303

P.O. Number

Prsht Rev.

First Issue

: 05/03/2009 This Issue

: NC

: // : 46085

Type

S.O. No. :

: LARGE FAB ASSY

**Part Number** 

**Due Date** 

**Drawing Name** 

: D22351

: BASKET RIBS

D2235 REV B1

**Drawing Number Project Number** 

: N/A : B1

**Drawing Revision** 

Material

: 11/03/2009

8 Um: Each

Written By Checked & Approved By

**Previous Run** 

Comment

: Est Rev:A

New Issue 08-12-01 DD verified by:EC

**Additional Product** 

Job Number:



Seq. #:

**Machine Or Operation:** 

**Description:** 

1.0

D31661

Basket Hoop

Comment: Qty.:

1.0000 Each(s)/Unit Total:

8.0000 Each(s)

2.0





Comment: LARGE FABRICATION RESOURCE 1

1- Pick D3166-1 and cut as per dwg D2235 using DT8302

2- remove identification markings on tube

3- deburr

INSPECT WORK TO CURRENT STEP



2 03.11



Comment: INSPECT WORK TO CURRENT STEP

4.0

3.0

PACKAGING 1

QC5

PACKAGING RESOURCE #1







Comment: PACKAGING RESOURCE #1

Identify and Stock

Location:


5.0

QC21

FINAL INSPECTION/W/O RELEASE





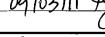

Job Completion

Comment: FINAL INSPECTION/W/O RELEASE

Dart Aerospace
----------------

Dart Ae	rospace Lt	td						
W/O:			WO	RK ORDER CHANGES	6			
DATE	STEP	PROCEDURE CHANGE			Ву	Date Qty	Approval Chief Eng / Prod Mgr	Approval QC Inspector
Part No:PAR #:		PAR #:	Fault Categ	ory: I	NCR: Yes	No DQA:	Date: _	
		olution:	Disposition:		QA: N/C Closed:			
NCR:			WORK ORDE	R NON-CONFORMAN	CE (NCF	₹)		
DATE	STEP Description of NC Section A Initial Chief Eng	<del></del>	Corrective Action Section B  Action Description		Verification		Approval	
		Section A	1 !	Chief Eng	Sign &	J JCCLION O	Chief Eng	QC Inspector

NCR:		WORK ORDER NON-CONFORMANCE (NCR)								
DATE	T	Description of NC	Corrective Action Section B			Verification	Ammuoval			
	STEP	Section A	Initial Chief Eng	Action Description Chief Eng	Sign & Date	Section C	Approval Chief Eng	Approval QC Inspector		
I								,		

NOTE: Date & initial all entries




DESIGN DRAWN BY DART AEROSPACE LTD VICTORIA INTERNATIONAL AIRPORT, CANADA

CHECKED APPROVED DRAWING NO. REV. B
DATE TITLE SCALE

94:12:16

DART AEROSPACE LTD
VICTORIA INTERNATIONAL AIRPORT, CANADA

REV. B
SCALE
BASKET RIBS

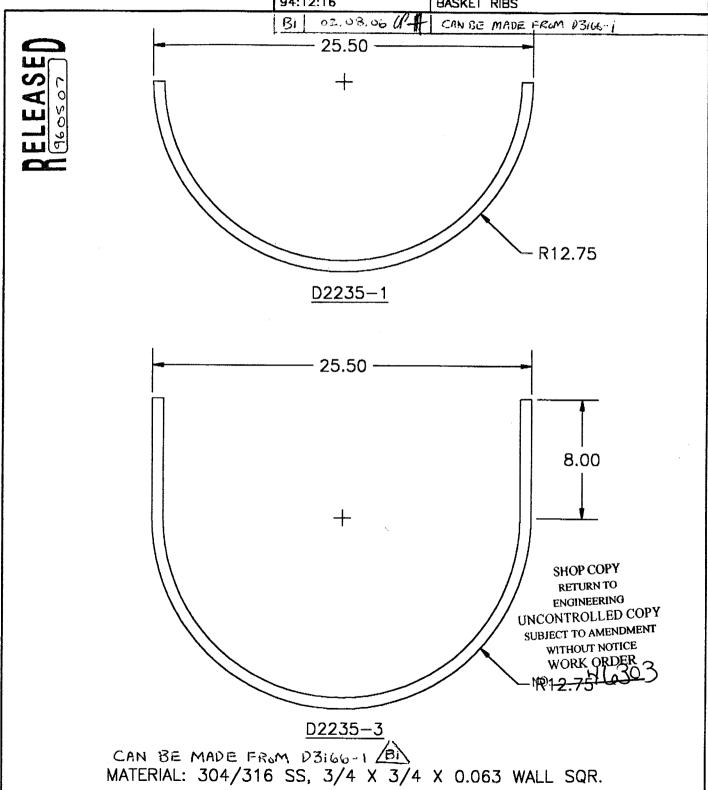

## **Dart Aerospace Ltd**

W/O:

DATE	STEP	PROCEDURE CHANGE	Ву	Date	Qty	Approval Chief Eng / Prod Mgr	Approval QC Inspector
Part No	):	PAR #: Fault Category: NCF	R: Yes	No <b>DQ</b>	Δ:	Date:	

WORK ORDER CHANGES

NCR:		WORK ORDER NON-CONFORMANCE (NCR)								
DATE	STEP	Description of NC	Corrective Action Section B			Varification	A			
		Section A	Initial Chief Eng	Action Description Chief Eng	Sign & Date	Verification Section C	Approval Chief Eng	Approval QC Inspector		
<del></del>										

NOTE: Date & initial all entries